


CORNER RECORD

Document Number 638-VV

City of _____

County of MERCED, California

Brief Legal Description N.W. CORNER LOT 928, BLOCK 46 OF PLANADA, 4 O.P. 44

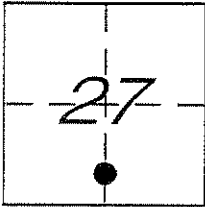

7/15

CORNER TYPE

Government Corner Control
Meander Property
Rancho Other
Date of Survey JUNE 4, 2013

COORDINATES (Optional)

N. _____
E. _____
Zone _____ NAD27 NAD83
NAD83 Epoch _____
Elev. _____
Vert. Datum: NGVD29 NAVD88
Meas. Units: Metric Imperial

Corner -- Left as found Found and tagged Established Reestablished Rebuilt

Identification and type of corner found: Evidence used to identify or procedure used to establish or reestablish the corner:

FOUND 1" IRON ROD CALLED 0.35' WEST OF TRUE POINT PER COUNTY FIELD BOOK NUMBER 717, PAGE 1.
MONUMENT TIED OUT PRIOR TO OVERLAY OF BRODRICK AVENUE AND CABRILLO STREET.

A description of the physical condition of the monument as found and as set or reset: SEE PAGE 2

SURVEYOR'S STATEMENT

This Corner Record was prepared by me or under my direction in conformance with

the Land Surveyor's Act on Sept. 30, 2013

Signed [Signature] P.L.S or ~~FILE~~ No. 4895



COUNTY SURVEYOR'S STATEMENT

This Corner Record was received Sept. 30, 2013

and examined and filed Sept. 30, 2013

Signed [Signature] P.L.S or ~~FILE~~ No. 4895

Title County Surveyor




County Surveyor's Comment _____

CABRILLO STREET

35'

35'

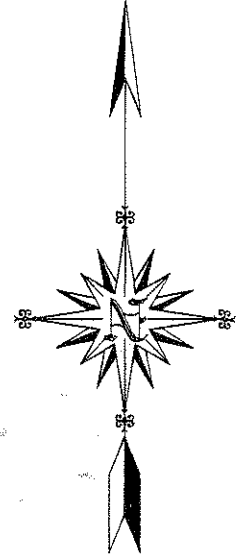

SCALE: 1" = 20'

PLANADA ELEMENTARY SCHOOL

BRODRICK AVENUE

35'

35'

SIDEWALK

FOUND 1" IRON ROD PER CO. F.B. 717, PG. 1.

9.22' SET 5/8" REBAR.

SIDEWALK

DRIVEWAY

PLANADA ELEMENTARY SCHOOL

19.06'

SET 5/8" REBAR.