


CORNER RECORD

Document Number 1351-0 (2)

City of _____

County of Merced, California

Brief Legal Description Centerline Monument for End of Curve on Olive Avenue

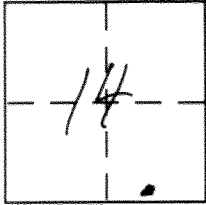

CORNER TYPE

Government Corner Control
Meander Property
Rancho Other
Date of Survey November 26, 2012

COORDINATES (Optional)

N. _____
E. _____
Zone _____ NAD27 NAD83
NAD83 Epoch _____
Elev. _____
Vert. Datum: NGVD29 NAVD88
Meas. Units: Metric Imperial

Corner - Left as found Found and tagged Established Reestablished Rebuilt

Identification and type of corner found: Evidence used to identify or procedure used to establish or reestablish the corner:

Monument destroyed by road reconstruction. Set 1" iron pipe, tagged "Merced Co. Surveyor" in monument well using ties set on Corner Record 1351-D dated October 3, 2012 at "STA 32+18.14 EC" per unrecorded survey 6-14-95.

A description of the physical condition of the monument as found and as set or reset: See page 2

SURVEYOR'S STATEMENT

This Corner Record was prepared by me or under my direction in conformance with the Land Surveyor's Act on April 2, 2013

Signed [Signature] P.L.S or ~~P.C.E.~~ No. 4895



COUNTY SURVEYOR'S STATEMENT

This Corner Record was received April 2, 2013

and examined and filed April 4, 2013

Signed [Signature] P.L.S or ~~P.C.E.~~ No. 4895

Title Acting County Surveyor



County Surveyor's Comment _____

1/2" REBAR
AT TOE OF BLUFF
17' FROM EDGE
OF PAVEMENT

1/2" REBAR
AT TOE OF BLUFF
17' FROM EDGE
OF PAVEMENT

39.63'

37.59'

SET 1" IRON PIPE, TAGGED
"MERCED CO. SURVEYOR" IN
MONUMENT WELL AT
"STA 32+18.14 EC" PER
UNRECORDED SURVEY 6-1A-95
MERCED COUNTY SURVEYORS OFFICE

25'

OLIVE
AVENUE


34.81'

61.96'

25'

1/2" REBAR
1' FROM FENCE

NAIL AND SHINER IN
AT NORTHEAST CORNER
OF FENCE POST

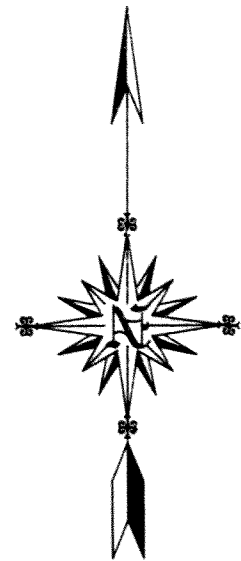

SCALE: 1" = 20'